MARATHON COUNTY PUBLIC LIBRARY
ADDITION AND REMODELING
WAUSAU, WISCONSIN

HSR L920154

JUNE 1993

HSR ASSOCIATES, INC.
Architecture/Engineering
La Crosse & Madison, Wisconsin

Index of Drawings

ARCHITECTURAL

A0	COVER SHEET
A1	SURVEY
A1.1	SITE REMOVAL PLAN
A2	SITE PLAN
A3	LANDSCAPE/GRADING PLAN
A4	SITE DETAILS
A5	BLDG ELEVS/EXT. WDO ELEVS/ALT.#2 WDO ELEVS
A6	BUILDING ELEVATIONS
A7	BASEMENT DEMOLITION PLAN
A8	FIRST FLOOR DEMOLITION PLAN
A9	SECOND FLOOR DEMOLITION PLAN
A10	ROOF DEMOLITION PLAN
A11	BASEMENT FLOOR PLAN
A12	FIRST FLOOR PLAN
A13	SECOND FLOOR PLAN
A14	THIRD FLOOR PLAN
A15	ROOF PLAN
A16	BASEMENT REF. CEILING PLAN
A17	FIRST FLOOR REF. CEILING PLAN
A18	SECOND FLOOR REF. CEILING PLAN
A19	BUILDING SECTIONS
A20	WALL SECTIONS
A21	WALL SECTIONS
A22	WALL SECTIONS
A23	WALL SECTIONS/DETAILS
A24	STAIRS 'A', 'B' & ELEVATOR SECTIONS
A25	STAIR C SECTION AND MISC. DETAILS
A26	WALL TYPE & MISC. DETAILS
A27	ROOM FINISH SCHEDULE
A28	DOOR SCHEDULE / DOOR TYPES
A29	LARGE SCALE TOILET PLANS
A30	DOOR/INTERIOR WDO FRAME ELEVATIONS
A31	DOOR & WINDOW DETAILS
A32	CASEWORK ELEVATIONS & DETAILS
A33	CASEWORK ELEVATIONS & DETAILS
A34	EXTERIOR WINDOW DETAILS
A35	MISC. BUILDING DETAILS
A36	ROOF DETAILS

STRUCTURAL

S1	FOUNDATION PLAN
S2	FIRST FLOOR FRAMING
S3	SECOND FLOOR FRAMING
S4	THIRD FLOOR FRAMING
S5	ROOF FRAMING
S6	DETAILS

PLUMBING

P1	PLUMBING SITE PLAN
P2	BASEMENT FLOOR PLAN
P3	FIRST FLOOR PLAN
P4	SECOND FLOOR PLAN
P5	THIRD FLOOR PLAN
P6	WASTE & VENT PIPING DIAGRAMS

MECHANICAL

M1	BASEMENT HVC PIPING PLAN
M2	BASEMENT HVC DUCTWORK PLAN
M3	FIRST FLOOR HVC PIPING PLAN
M4	FIRST FLOOR HVC DUCTWORK PLAN
M5	SECOND FLOOR HVC PIPING PLAN
M6	SECOND FLOOR HVC DUCTWORK PLAN
M7	THIRD FLOOR HVC/DUCTWORK/PIPING PLAN
M8	LARGE SCALE MECHANICAL ROOM PLANS/SECTIONS
M9	DETAILS
M10	SCHEDULES

ELECTRICAL

E1	ELECTRICAL SITE PLAN
E2	BASEMENT LIGHTING PLAN
E3	BASEMENT POWER PLAN
E4	FIRST FLOOR LIGHTING PLAN
E5	FIRST FLOOR POWER PLAN
E6	SECOND FLOOR LIGHTING PLAN
E7	SECOND FLOOR POWER PLAN
E8	THIRD FLOOR ELECTRICAL PLAN
E9	BASEMENT SYSTEMS PLAN
E10	FIRST FLOOR SYSTEMS PLAN
E11	SECOND FLOOR SYSTEMS PLAN
E12	POWER RISER RISER DIAGRAM
E13	SCHEDULES

PHASING:

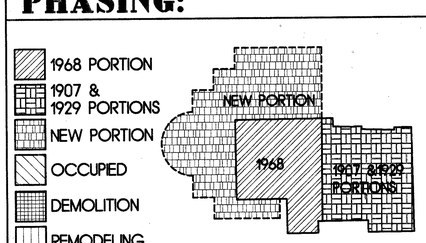

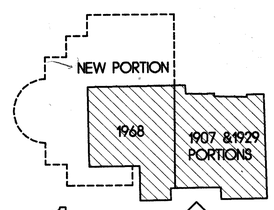

1

PHASE 1:
1. TIME PERIOD TWO-FOUR MONTHS FROM START OF CONSTRUCTION.
2. CONTRACTOR CAN PROCEED WITH ANY ADDITION WORK THAT DOES NOT INTERFERE WITH EXITING OF THE EXISTING 1968,1929,1907 BUILDING AS IT WILL BE OCCUPIED DURING PHASE 1.
3. TEMPORARY WORK THAT IS REQUIRED IN THE 1907/1929 PORTION OF THE LIBRARY FOR OCCUPANCY DURING PHASE 2.

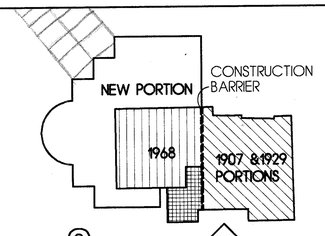

2

PHASE 2:
1. LIBRARY SHALL VACATE THE 1968 PORTION OF THE BUILDING DURING THIS PERIOD OF TIME. THE 1907/1929 PORTION SHALL CONTINUE TO BE OCCUPIED.
2. WORK SHALL INCLUDE THE NEW ADDITION AND REMODELING OF THE 1968 PORTION OF THE EXISTING BUILDING, TO THE EXTENT THAT THE 1907/1929 PORTION REMAIN STANDING AND OCCUPIED.
3. PROVIDE TEMPORARY ENTRANCE TO ADDITION AND REMODELED 1968 PORTION @ STAIR 'C'.

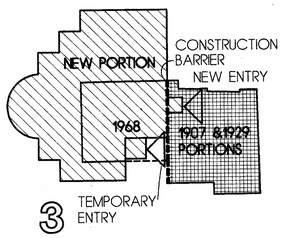

3

PHASE 3:
1. LIBRARY SHALL MOVE OUT OF THE 1907/1929 PORTION AND OCCUPY THE PHASE 1 & 2 WORK.
2. DEMOLITION OF THE 1907/1929 PORTION SHALL PROCEED AS SOON AS THE STRUCTURE IS VACATED.
3. AFTER DEMOLITION OF THE 1907/1929 PORTION, WORK CAN PROCEED ON THE NORTH SIDE OF THE PHASE 1 & 2 WORK.
4. REMOVE TEMPORARY ENTRANCE WORK @ STAIR TOWER 'C' AND COMPLETE WORK.

CODE DATA:

CLASS OF CONSTRUCTION-	TYPE 3- METAL FRAME PROTECTED
OCCUPANCY-	CHAPTER 56- LIBRARIES
AUTOMATIC SPRINKLERS-	YES
FIRE SEPARATIONS-	SEE SHEETS A16, A17 & A18
EXIT DISTANCE-	200'
AGGREGATE EXIT WIDTH-	30"/100 PEOPLE
OCCUPANTS-	72 STAFF 128 PATRONS 200 TOTAL
FLOOR LOADING-	150 PSF ON BASEMENT, 1ST, 2ND FLOORS 60 PSF ON 3RD FLOOR
SANITARY FACILITIES-	WATER CLOSETS- MEN 1/10 WOMEN 1/15 URINALS- 1/40 LAVATORIES- 1/15

Set Number 5

HSR ASSOCIATES INC.
RECEIVED
JAN 5 1995
ELLIS STONE AS-BUILT DRAWGS

A0

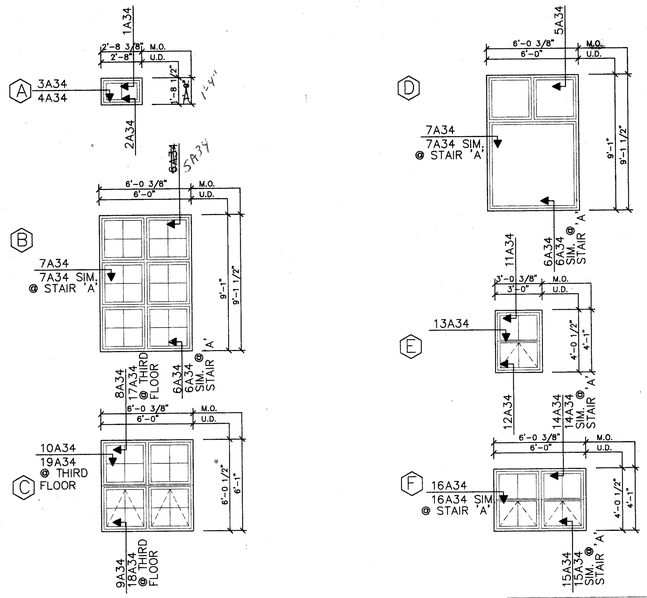

3 WINDOW SCHEDULE

1/4"

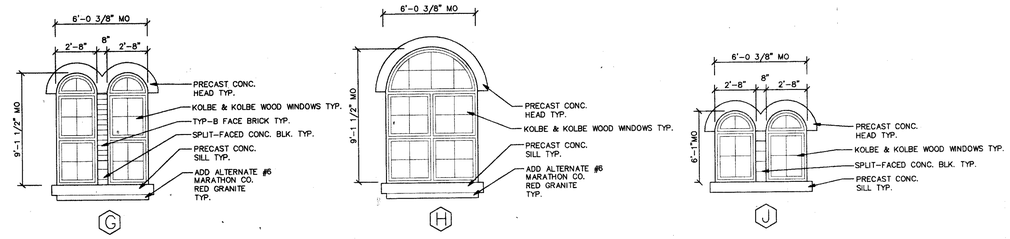

4 ADD ALTERNATE #2

SECOND FLOOR WINDOWS @ CURVE 1/4"

5 ADD ALTERNATE #2

SECOND FLOOR WINDOWS @ MAIN STAIR TOWER "C" & THIRD FL @ NORTH WALL ABOVE ENTRANCE PORTICO 1/4"

6 ADD ALTERNATE #2

THIRD FLOOR WINDOWS @ MAIN STAIR TOWER 1/4"

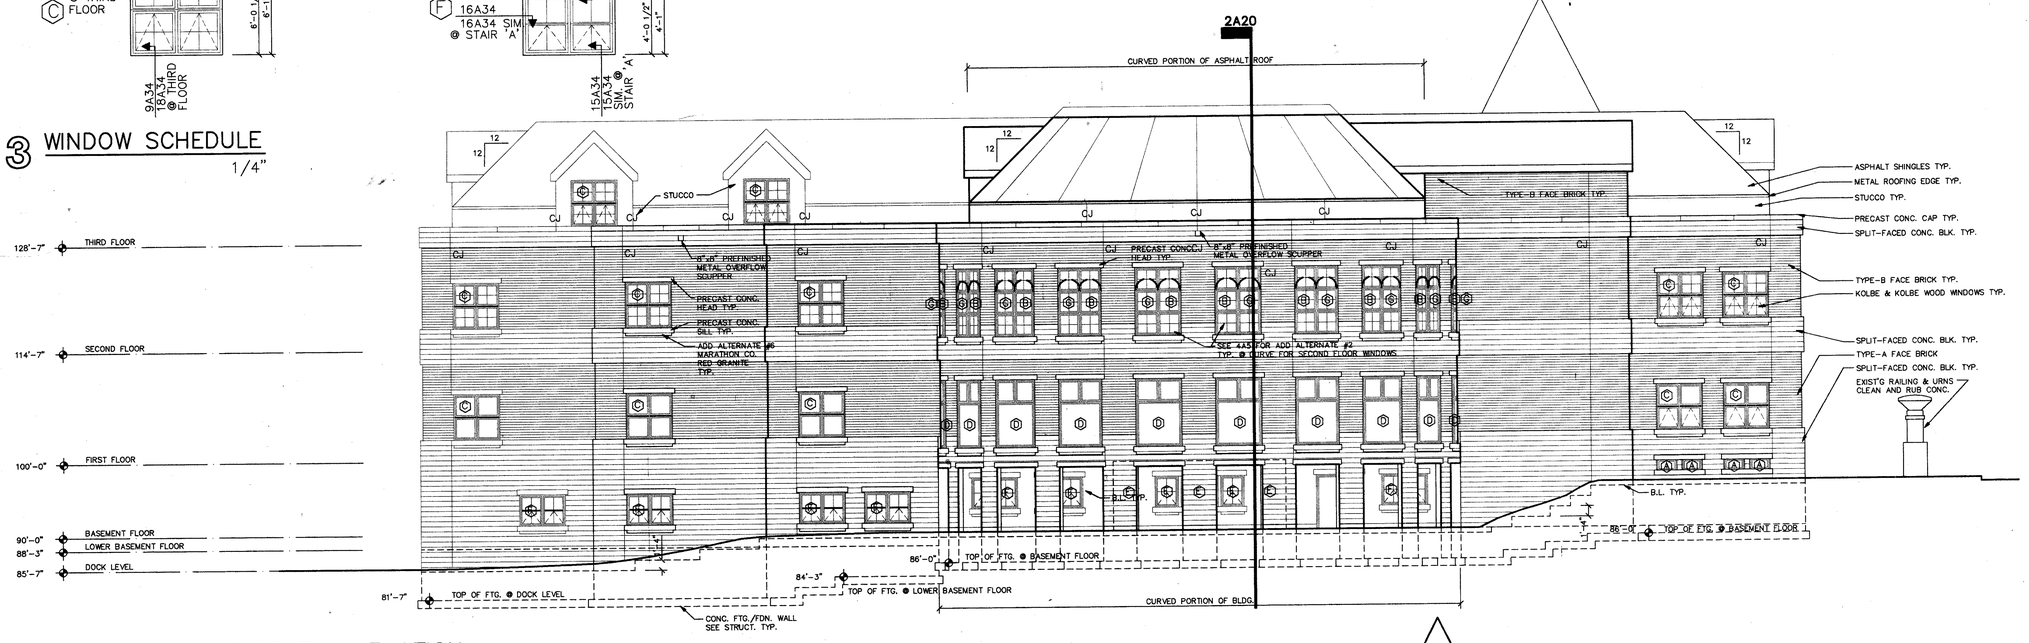

1 SOUTH ELEVATION

1/8"

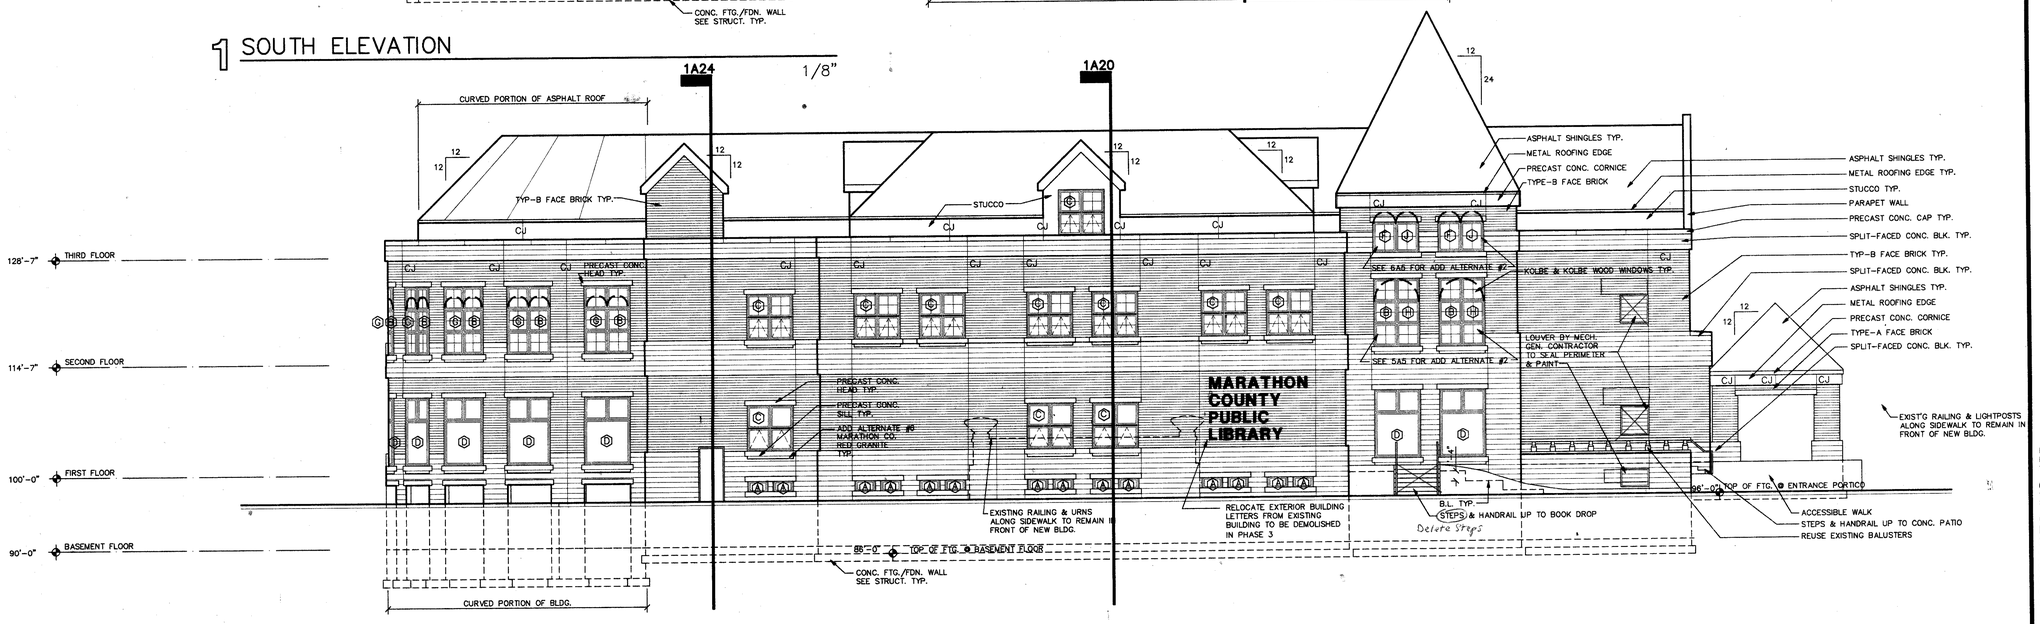

2 EAST ELEVATION

1/8"

PROJECT MARATHON COUNTY PUBLIC LIBRARY
ADDITION AND REMODELING
WAUSAU, WISCONSIN
HSR 920154

DRAWING ELEVATIONS
DATE JUNE 1993
DRAWN BY D. RAMSEY
REVISION

FILE # 92154e5
LAST UPDATE 15 JUNE 1993

HSR ASSOCIATES INC
ARCHITECTURE
ENGINEERING
LA CROSSE AND MADISON WI

A5

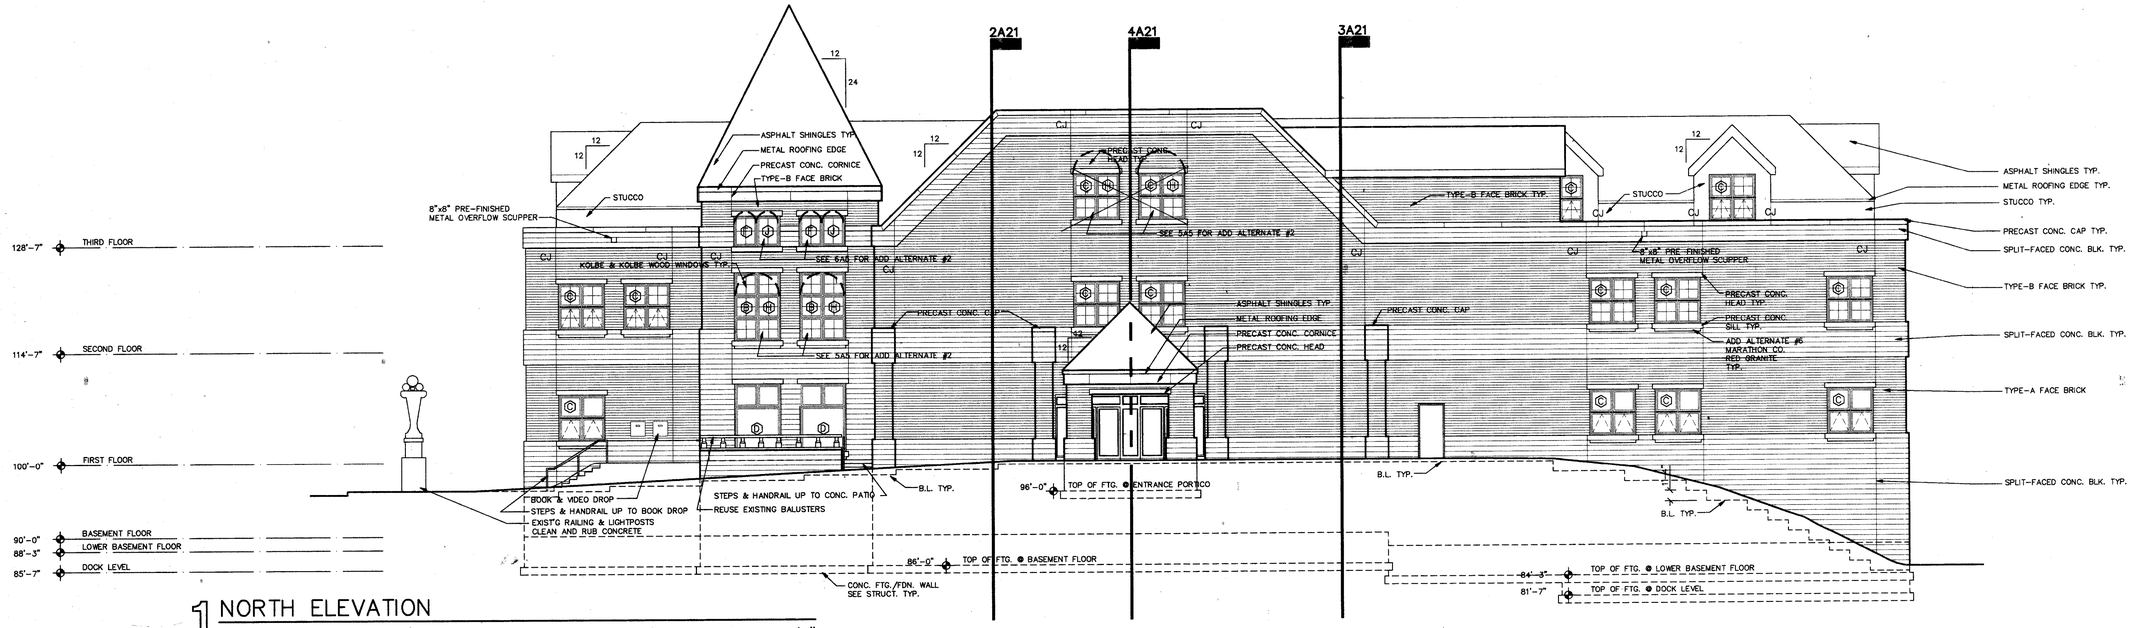

1 NORTH ELEVATION

1/8"

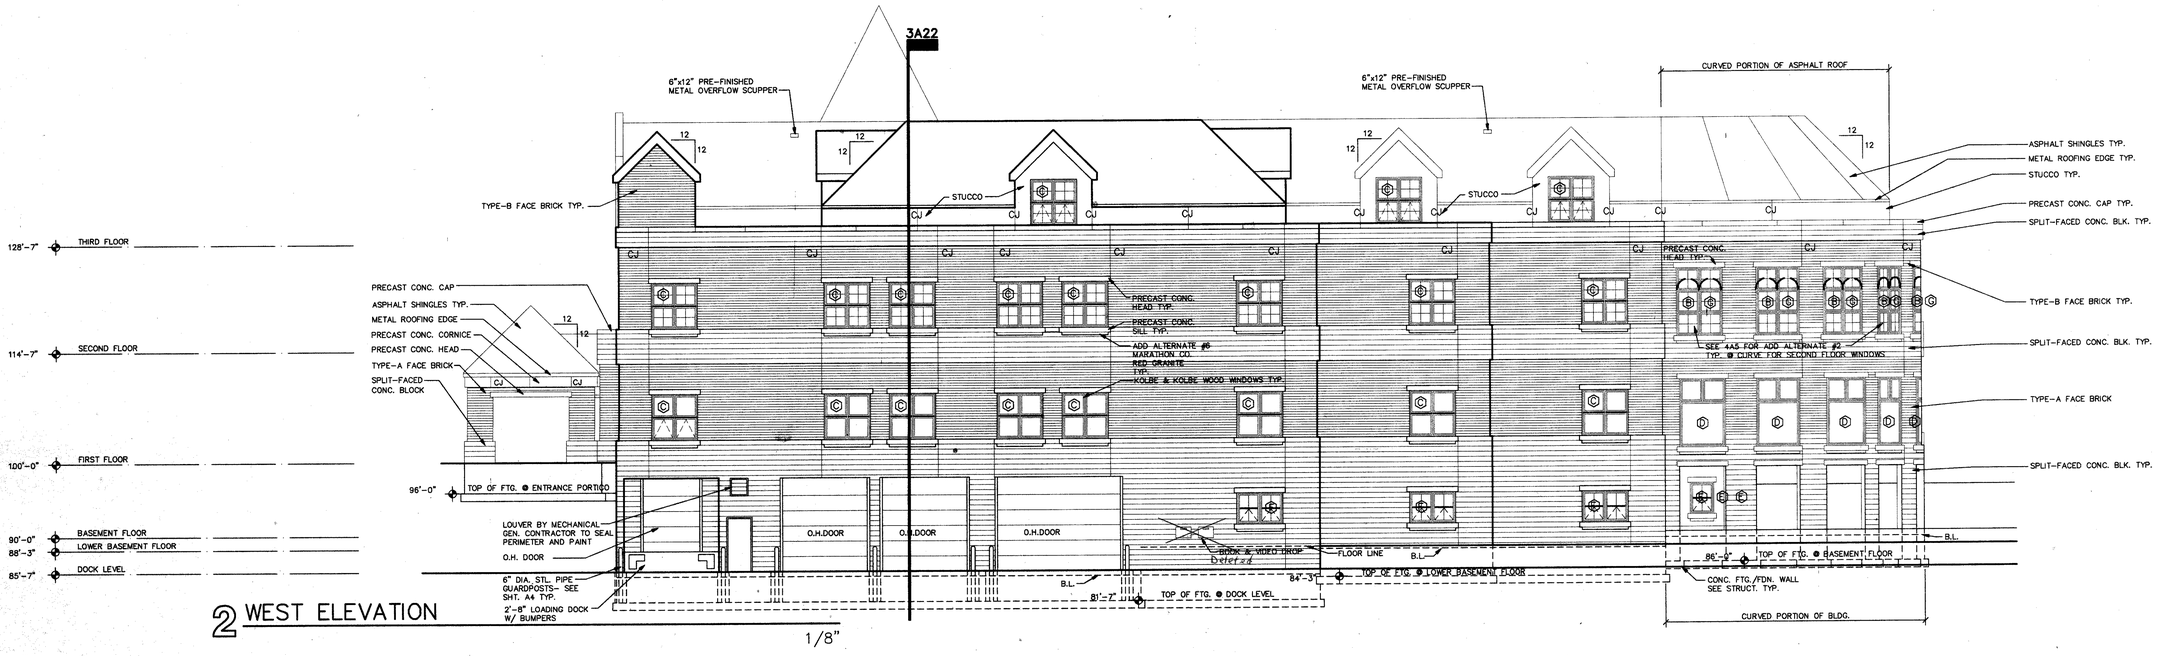

2 WEST ELEVATION

1/8"

PROJECT MARATHON COUNTY PUBLIC LIBRARY
ADDITION & REMODELING
WAUSAU, WISCONSIN
HSR 920154

DRAWING ELEVATIONS
DATE JUNE 1993
DRAWN BY D. RAMSEY
REVISION

FILE # 92154A6
LAST UPDATE 6-16-93

HSR ASSOCIATES INC
ARCHITECTURE
ENGINEERING
LA CROSSE AND MADISON WI

A6

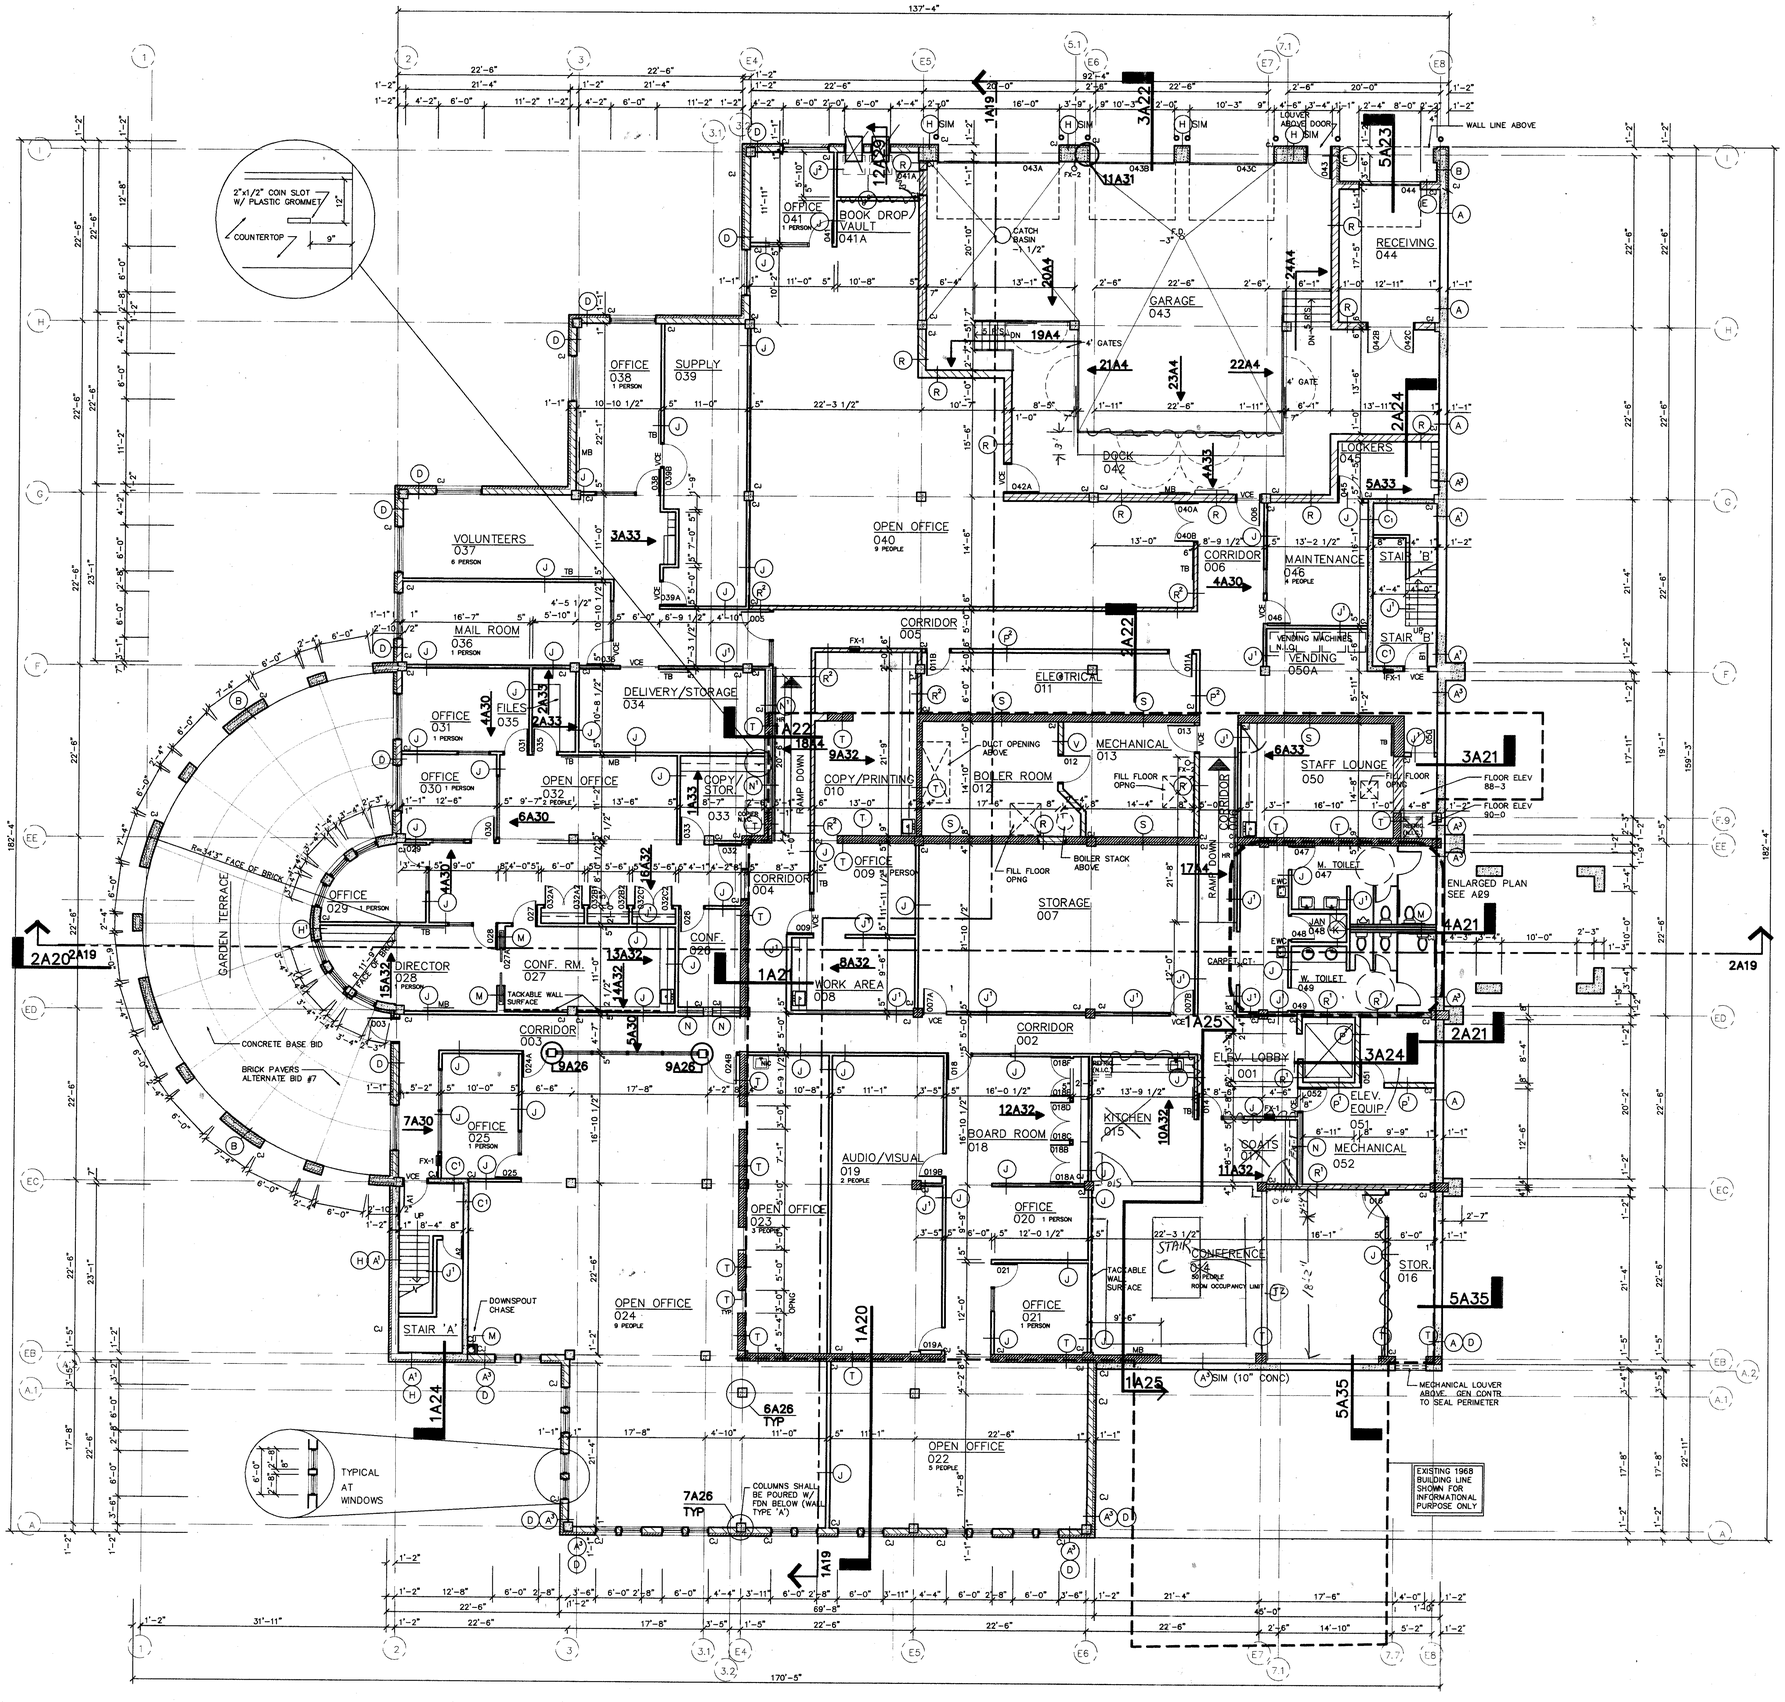

1 BASEMENT FLOOR PLAN
1/8" = 1'-0"

GENERAL NOTES:

(A) — SYMBOL INDICATES WALL TYPE – SEE SHEET A26 FOR DETAILS

(A) SYMBOL INDICATES WDO TYPE – SEE SHEET A30 FOR ELEVATIONS.

ALL PARTITIONS ARE TO EXTEND FULL HEIGHT TO BOT OF STRUCT. ABOVE UNLESS OTHERWISE INDICATED.

VERIFY SIZE AND LOCATIONS OF ALL MECH. WALL OPENINGS GEN. CONTR. TO SEAL LOUVER PERIMETER AND PAINT – TYP.

FIELD VERIFY EXISTING BLD'G DIMENSIONS REQUIRED FOR NEW CONSTRUCTION PRIOR TO ANY FABRICATION.

PROVIDE VERTICAL C.J'S FULL HEIGHT OF WALL AT BOTH JAMBS OF ALL INTERIOR DOOR FRAMES AT ALL MAS. AND GYP. BD./MTL. STUD PARTITIONS – TYPICAL – OTHER C.J. LOCATIONS AS INDICATED ON PLANS.

SEE SHEET A29 FOR LARGE SCALE TOILET ROOM PLANS.

GEN. CONTR. TO PROVIDE CONC. EQUIP. PADS/CURBS AS REQ'D FOR MECH/ELECTRICAL EQUIP. – VERIFY SIZE/PROFILE/LOCATIONS WITH MECH/ELECTRICAL.

GEN. CONTR. TO PROVIDE WOOD BLK'G BETWEEN MTL. STUDS AS REQ'D FOR CASEWORK/HANDRAIL/TOILET ACCESSORIES/ETC. MOUNTING.

MB = MARKER BOARD
TB = TACK BOARD
ALL MARKER AND TACK BOARDS ARE 4'x4' W/ TOP MOUNTED AT 7'-0"

BASEMENT–BUILDING OCCUPANCY

50 STAFF
0 PATRONS
50 TOTAL

PROJECT MARATHON COUNTY PUBLIC LIBRARY
ADDITION AND REMODELING
WAUSAU, WISCONSIN
L920154

DRAWING BASEMENT FLOOR PLAN
DATE JUNE 1993
DRAWN BY BBS
REVISION

FILE # 92154A11
LAST UPDATE 6-21-93

HSR ASSOCIATES INC
ARCHITECTURE
ENGINEERING
LA CROSSE AND MADISON WI

A11

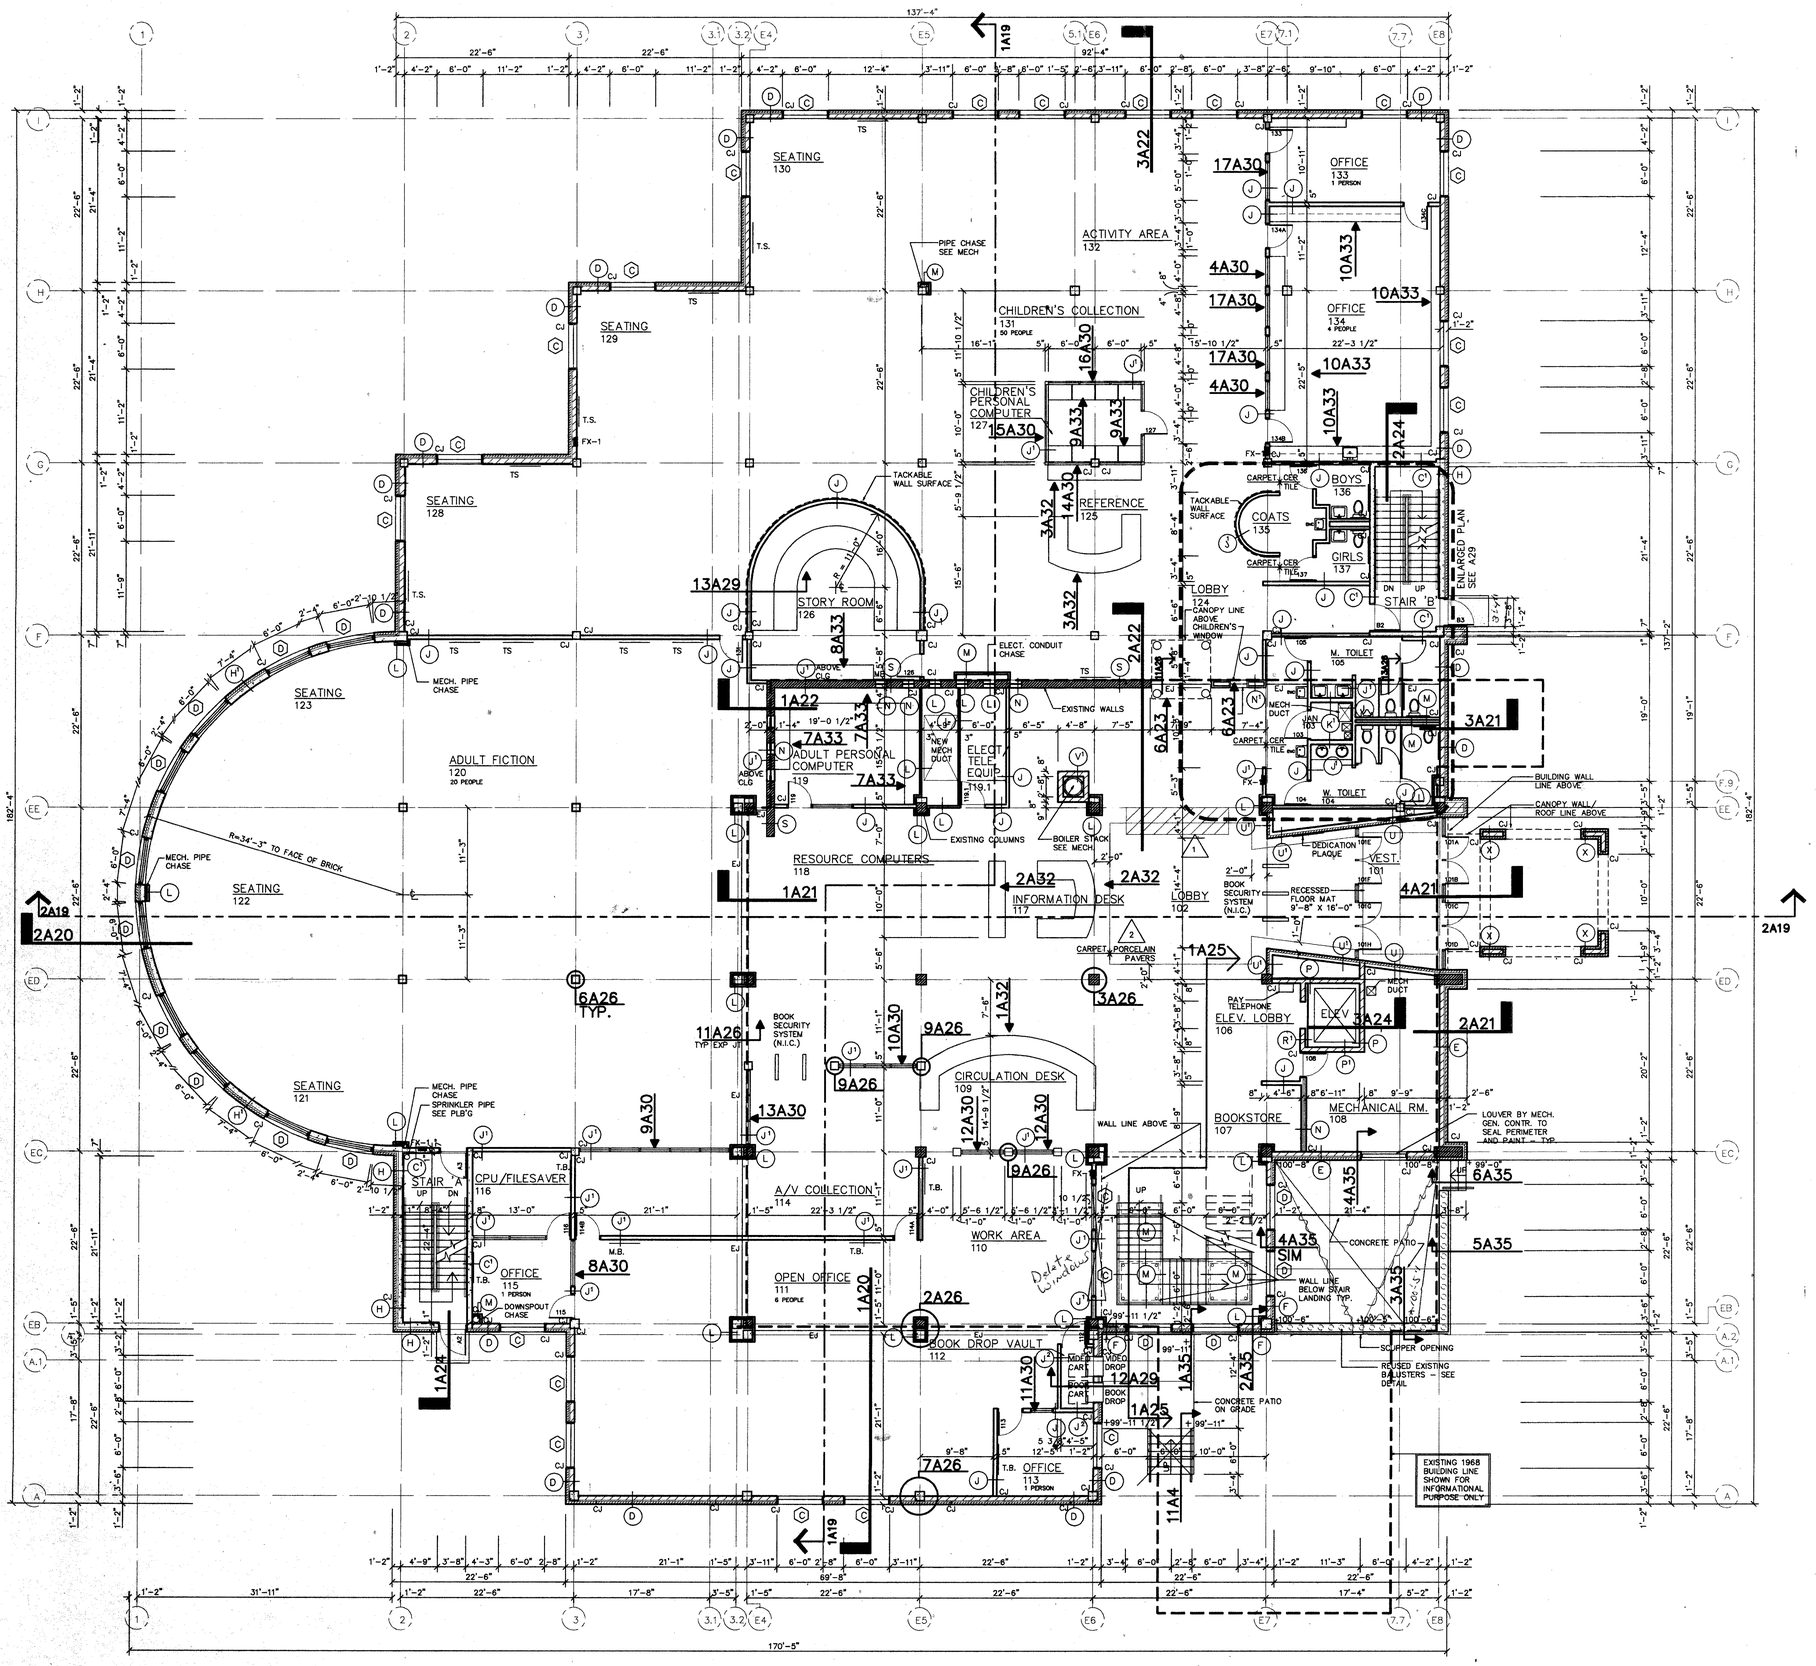

GENERAL NOTES:
(A) SYMBOL INDICATES WALL TYPE – SEE SHEET A26 FOR DETAILS
(A) SYMBOL INDICATES WDO TYPE – SEE SHEET A30 FOR ELEVATIONS.
ALL PARTITIONS ARE TO EXTEND FULL HEIGHT TO BOT OF STRUCT. ABOVE UNLESS OTHERWISE INDICATED.
VERIFY SIZE AND LOCATIONS OF ALL MECH. WALL OPENINGS GEN. CONTR. TO SEAL LOUVER PERIMETER AND PAINT – TYP.
FIELD VERIFY EXISTING BLD'G DIMENSIONS REQUIRED FOR NEW CONSTRUCTION PRIOR TO ANY FABRICATION.
PROVIDE VERTICAL C.J'S FULL HEIGHT OF WALL AT BOTH JAMBS OF ALL INTERIOR DOOR FRAMES AT ALL MAS. AND GYP. BD./MTL. STUD PARTITIONS – TYPICAL – OTHER C.J. LOCATIONS AS INDICATED ON PLANS.
SEE SHEET A29 FOR LARGE SCALE TOILET ROOM PLANS.
GEN. CONTR. TO PROVIDE CONC. EQUIP. PADS/CURBS AS REQ'D FOR MECH/ELECTRICAL EQUIP. – VERIFY SIZE/PROFILE/LOCATIONS WITH MECH/ELECTRICAL.
GEN. CONTR. TO PROVIDE WOOD BLK'G BETWEEN MTL. STUDS AS REQ'D FOR CASEWORK/HANDRAIL/TOILET ACCESSORIES/ETC. MOUNTING.
T.B. = 4'-0" X4'-0" TACKBOARD – MOUNT TOP AT 7'-0" A.F.F.
M.B. = 4'-0" X4'-0" MARKERBOARD – MOUNT TOP AT 7'-0" A.F.F.
T.S. = 8'-0" LONG TACKSTRIP – MOUNT TOP AT 7'-0" A.F.F.
EJ AT WALLS SIM TO 11A26

MISC. NOTES:
(1) FILL EXISTING FLOOR SLAB OPN'G – SEE STRUCT. FOR DETAIL
(2) PORCELAIN PAVERS BASE BID – ADD ALTERNATE #6 TO BE MARATHON COUNTY RED GRANITE.

FIRST FLOOR OCCUPANCY	
13	STAFF
70	PATRONS
83	TOTAL

1 FIRST FLOOR PLAN
1/8" = 1'-0"

PROJECT MARATHON COUNTY PUBLIC LIBRARY
ADDITION AND REMODELING
WAUSAU, WISCONSIN
L920154

DRAWING FIRST FLOOR PLAN
DATE JUNE 1993
DRAWN BY M. JOHNSON & B. SIMONSON
REVISION

FILE # 92154A12
LAST UPDATE 6-18-93

HSR ASSOCIATES INC
ARCHITECTURE
ENGINEERING
LA CROSSE AND MADISON WI

A12

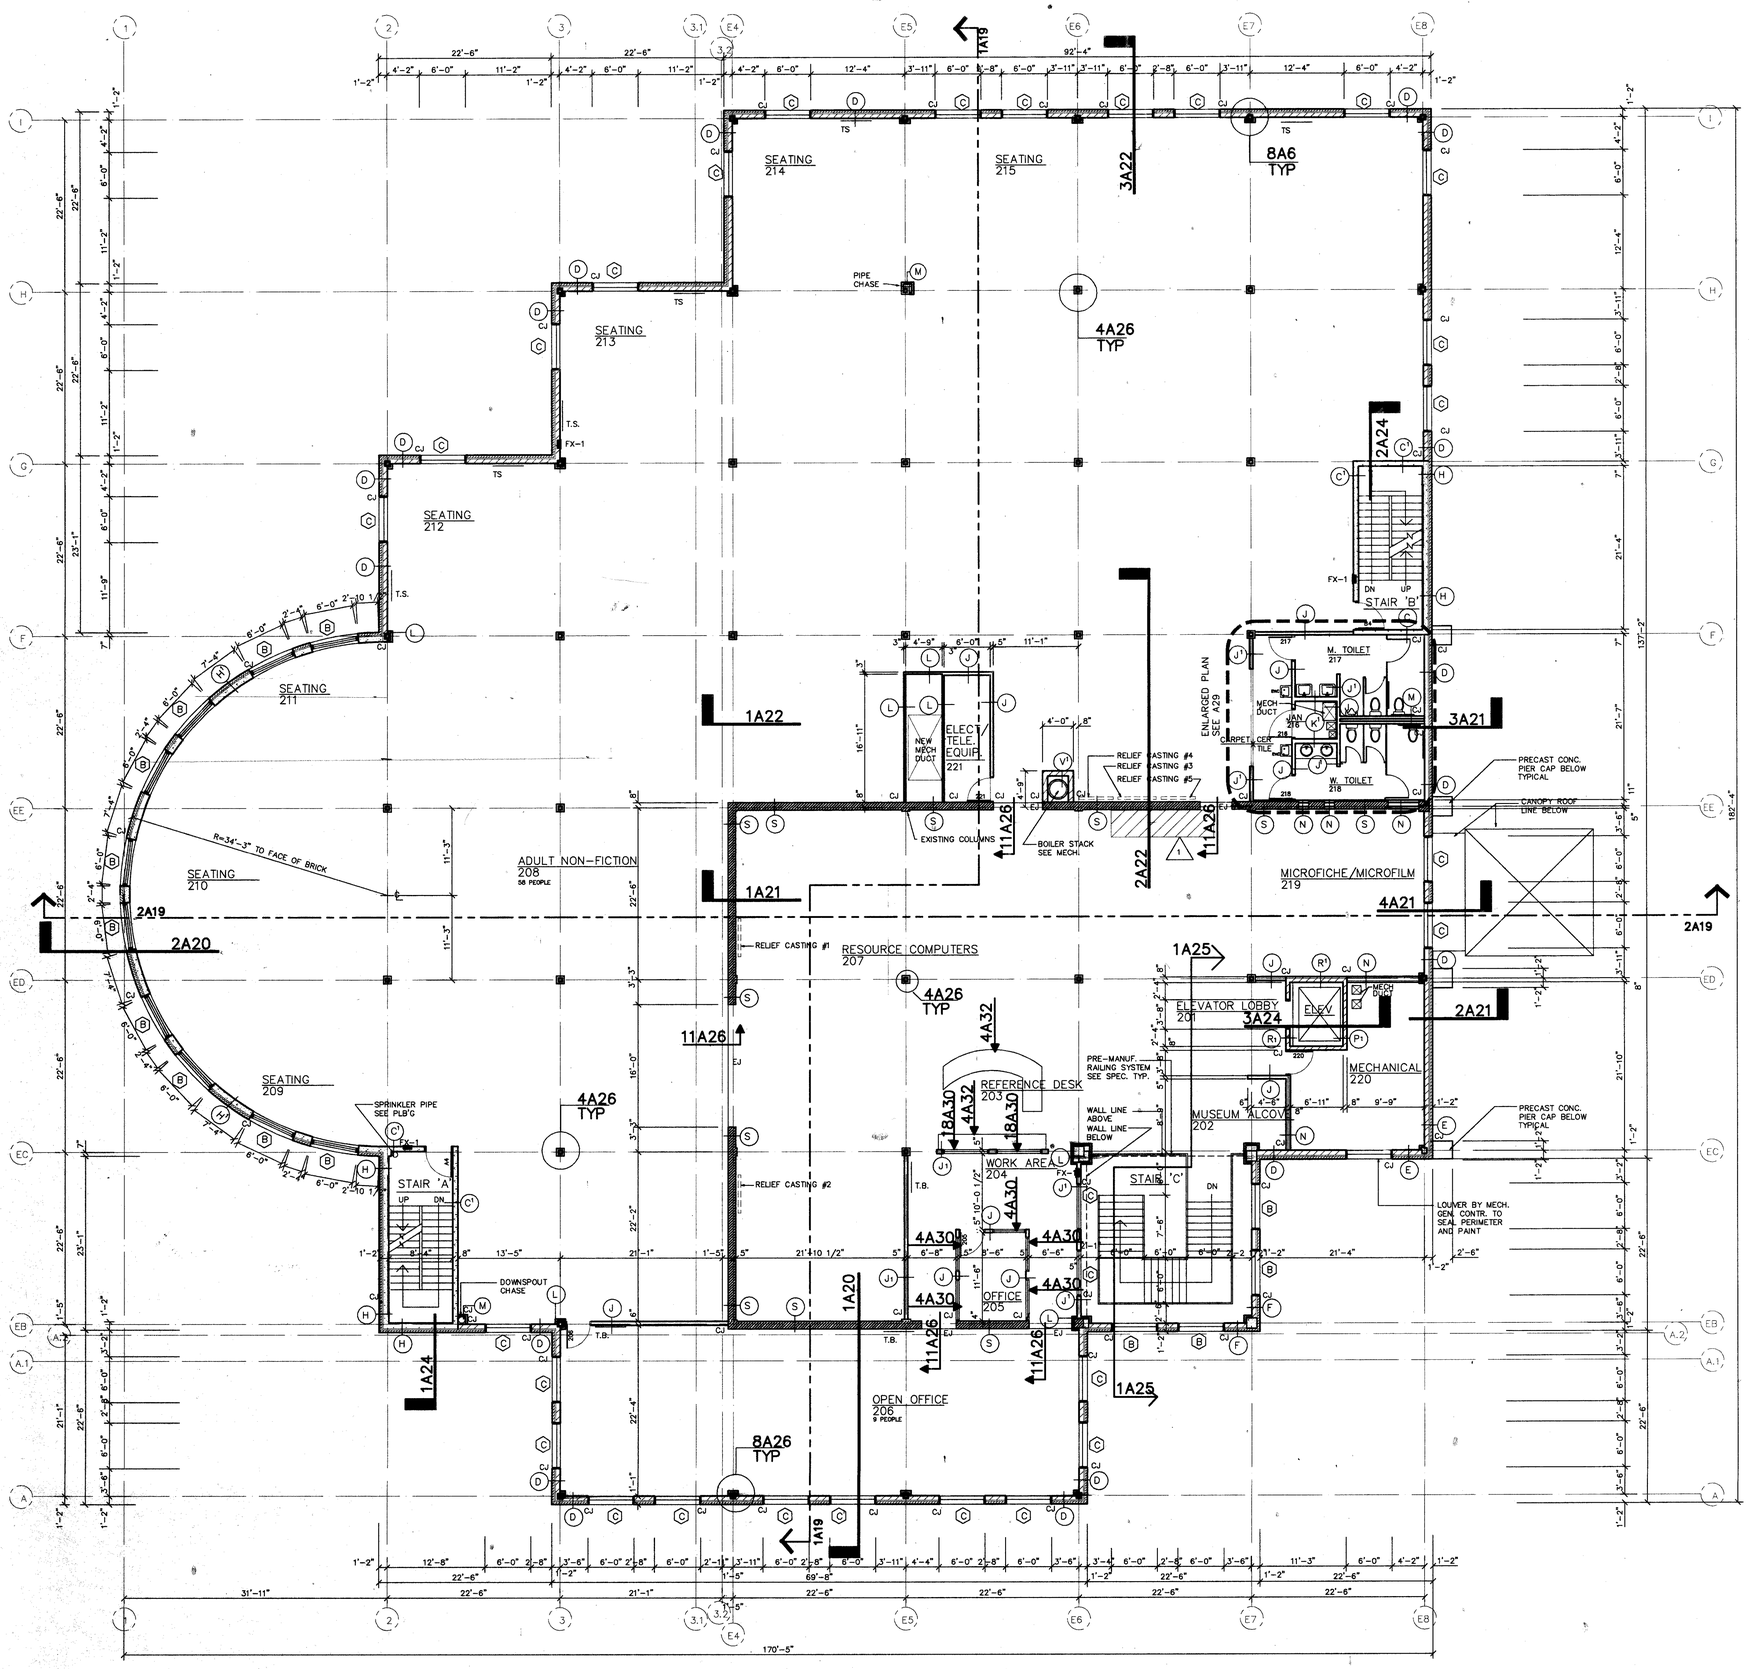

1 SECOND FLOOR PLAN
1/8" = 1'-0"

GENERAL NOTES:

(A)	SYMBOL INDICATES WALL TYPE – SEE SHEET A26 FOR DETAILS
(A)	SYMBOL INDICATES WDO TYPE – SEE SHEET A30 FOR ELEVATIONS.
	ALL PARTITIONS ARE TO EXTEND FULL HEIGHT TO BOT OF STRUCT. ABOVE UNLESS OTHERWISE INDICATED.
	VERIFY SIZE AND LOCATIONS OF ALL MECH. WALL OPENINGS GEN. CONTR. TO SEAL LOUVER PERIMETER AND PAINT – TYP.
	FIELD VERIFY EXISTING BLD'G DIMENSIONS REQUIRED FOR NEW CONSTRUCTION PRIOR TO ANY FABRICATION.
	PROVIDE VERTICAL C.J'S FULL HEIGHT OF WALL AT BOTH JAMBS OF ALL INTERIOR DOOR FRAMES AT ALL MAS. AND GYP. BD./MTL. STUD PARTITIONS – TYPICAL – OTHER C.J. LOCATIONS AS INDICATED ON PLANS.
	SEE SHEET A29 FOR LARGE SCALE TOILET ROOM PLANS.
	GEN. CONTR. TO PROVIDE CONC. EQUIP. PADS/CURBS AS REQ'D FOR MECH/ELECTRICAL EQUIP. – VERIFY SIZE/PROFILE/LOCATIONS WITH MECH/ELECTRICAL.
	GEN. CONTR. TO PROVIDE WOOD BLK'G BETWEEN MTL. STUDS AS REQ'D FOR CASEWORK/HANDRAIL/TOILET ACCESSORIES/ETC. MOUNTING.
	T.B. = 4'-0" X4'-0" TACKBOARD – MOUNT TOP AT 7'-0" A.F.F.
	M.B. = 4'-0" X4'-0" MARKERBOARD – MOUNT TOP AT 7'-0" A.F.F.
	T.S. = 8'-0" X4'-0" TACKSTRIP – MOUNT TOP AT 7'-0" A.F.F.

MISC. NOTES:

1	FILL EXISTING FLOOR SLAB OPN'G – SEE STRUCT. FOR DETAIL

SECOND FLOOR OCCUPANCY
9 STAFF
58 PATRONS
67 TOTAL

PROJECT MARATHON COUNTY PUBLIC LIBRARY
ADDITION AND REMODELING
WAUSAU, WISCONSIN
L920154

DRAWING SECOND FLOOR PLAN
DATE JUNE 1993
DRAWN BY M. JOHNSON & B. SIMONSON
REVISION

FILE # 92154A13 1/8 scale
LAST UPDATE 6-21-93

HSR ASSOCIATES INC
ARCHITECTURE
ENGINEERING
LA CROSSE AND MADISON WI

A13

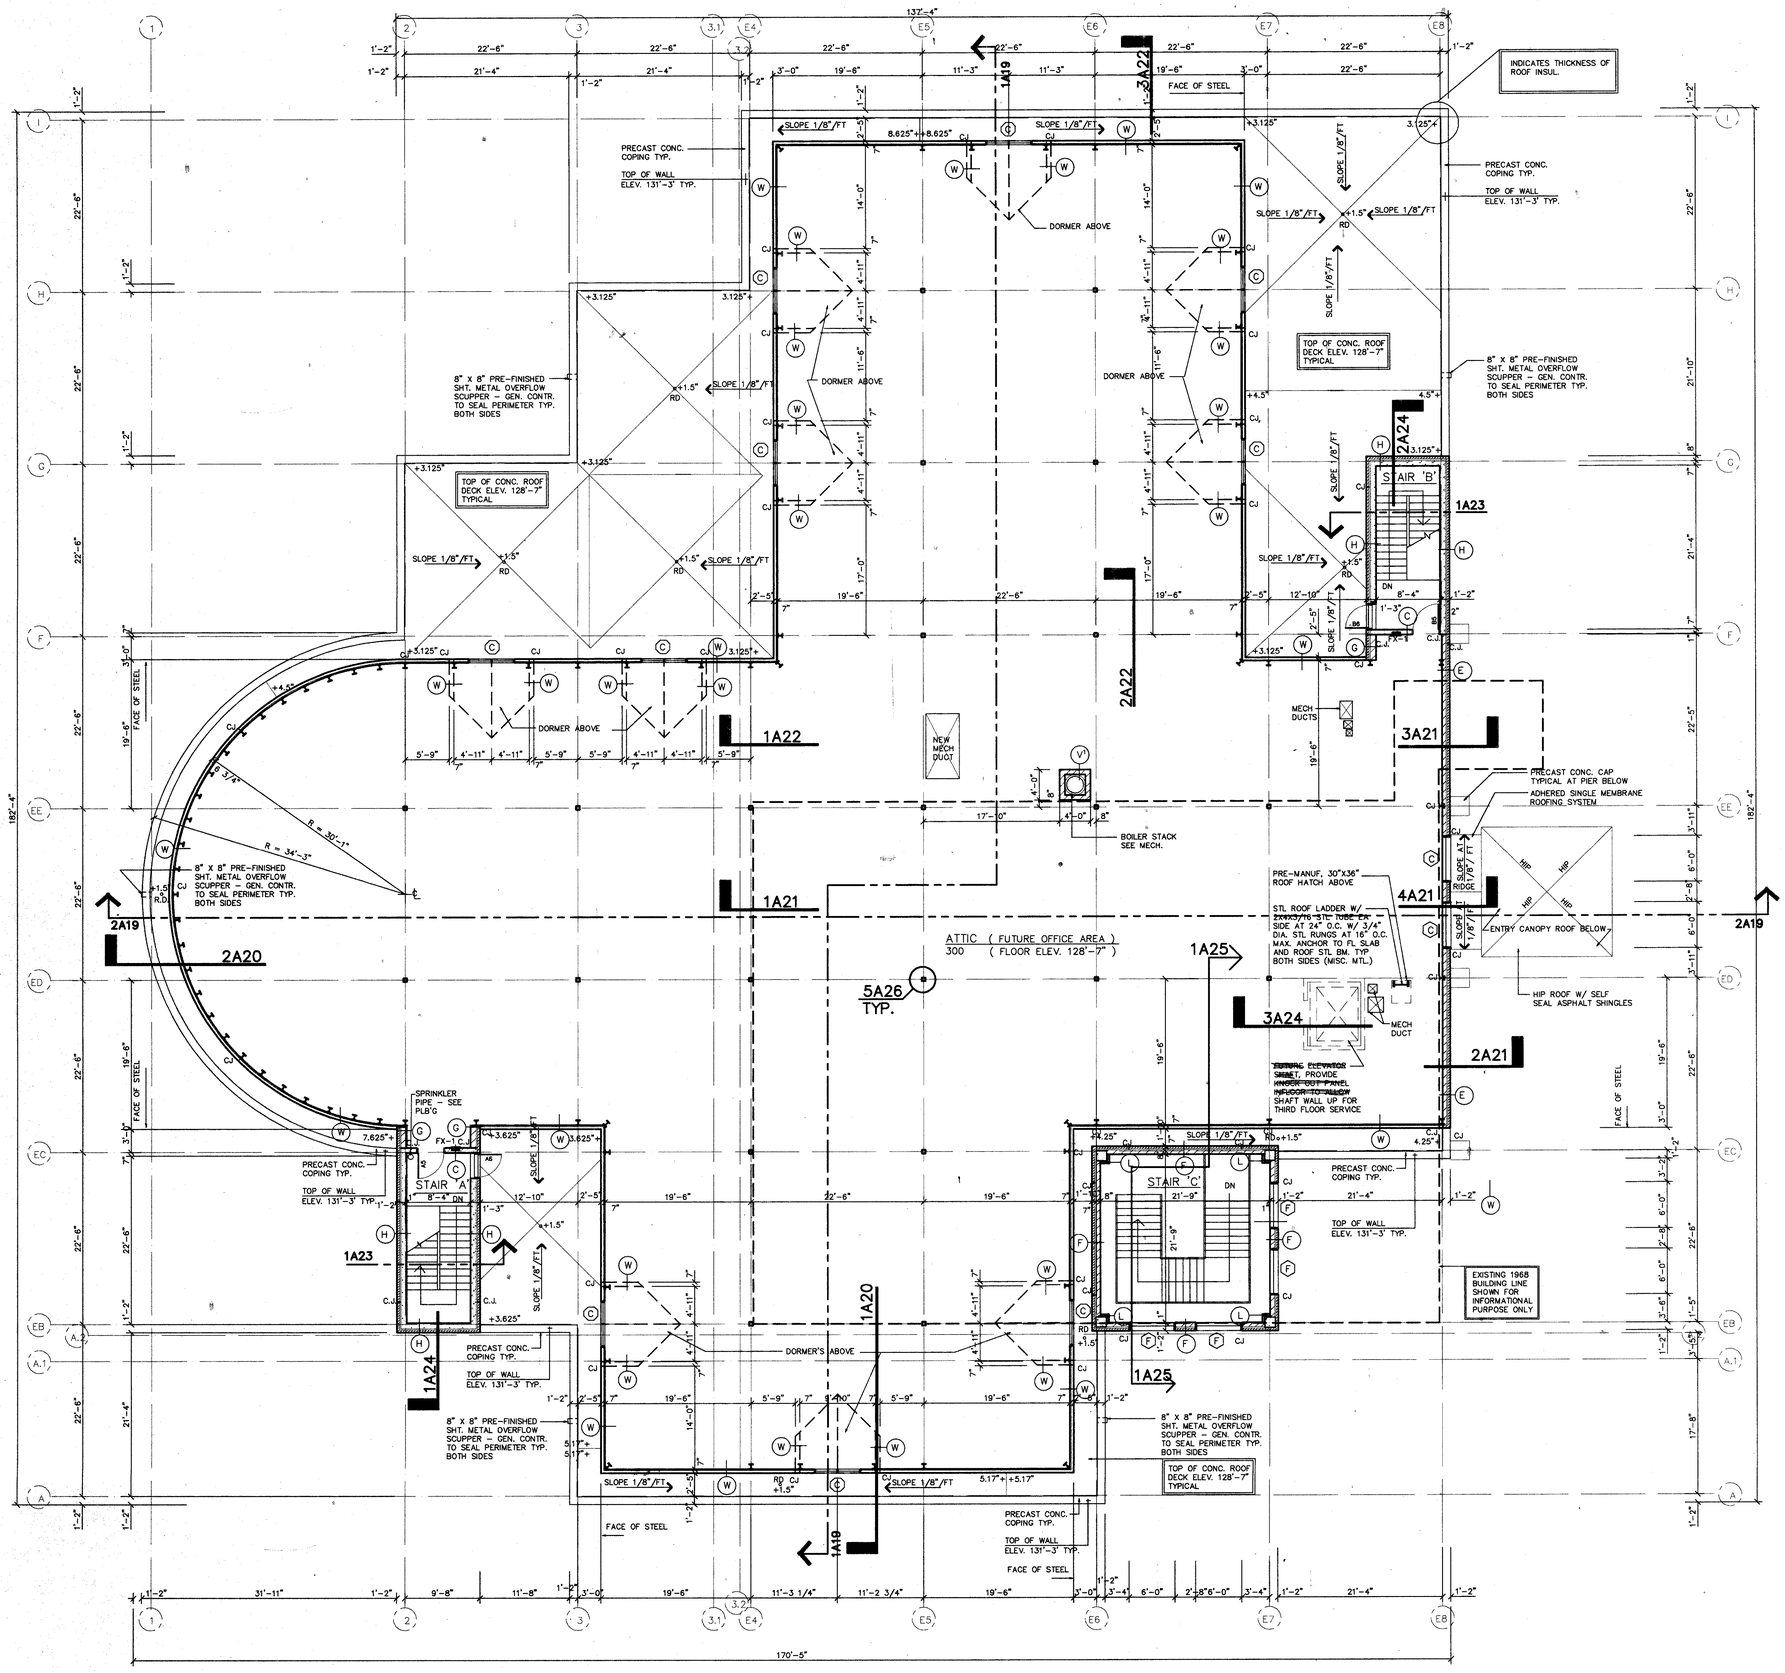

GENERAL NOTES:

(A)	SYMBOL INDICATES WALL TYPE - SEE SHEET A26 FOR DETAILS
(A)	SYMBOL INDICATES WDO TYPE - SEE SHEET A30 FOR ELEVATIONS.
	ALL PARTITIONS ARE TO EXTEND FULL HEIGHT TO BOT OF STRUCT. ABOVE UNLESS OTHERWISE INDICATED.
	VERIFY SIZE AND LOCATIONS OF ALL MECH. WALL/FLOOR OPN'GS GEN. CONTR. TO SEAL LOUVER PERIMETER AND PAINT - TYP.
	FIELD VERIFY EXISTING BLD'G DIMENSIONS REQUIRED FOR NEW CONSTRUCTION PRIOR TO ANY FABRICATION.
	PROVIDE VERTICAL C.J'S FULL HEIGHT OF WALL AT BOTH JAMBS OF ALL INTERIOR DOOR FRAMES AT ALL MAS. AND GYP. BD./MTL. STUD PARTITIONS - TYPICAL - OTHER C.J. LOCATIONS AS INDICATED ON PLANS.

TYPICAL ROOF NOTES:

ALL NEW FLAT ROOF AREAS ARE TO BE ADHERED SINGLE MENBRANE ROOFING SYSTEM WITH TAPERED ROOF INSUL. (R=5.65/INCH) OVER CONC. DECK ROOF INSULATION THICKNESS AS SHOWN ON PLAN
VERIFY LOCATION AND SIZE OF ALL MECHANICAL OPENINGS WITH HVC AND PLB'G. MECH. CONTR. TO PROVIDE PRE-MANUF. ROOF EQUIP. CURBS TYPICAL.

1 THIRD FLOOR PLAN
1/8" = 1'-0"

PROJECT MARATHON COUNTY PUBLIC LIBRARY
ADDITION AND REMODELUNG
WAUSAU, WISCONSIN
L920154
THIRD FLOOR PLAN
JUNE 1993
MLJ

DRAWING
DATE
DRAWN BY
REVISION

FILE # 92154A14 1/8 scale
LAST UPDATE
18 JUNE 1993

HSR ASSOCIATES INC
ARCHITECTURE
ENGINEERING
LA CROSSE AND MADISON WI

A14

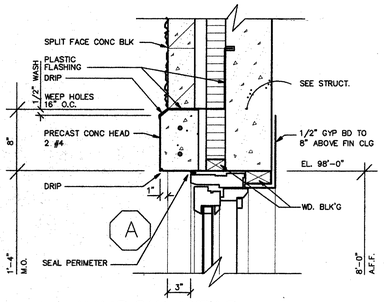

1 WINDOW HEAD
1 1/2"

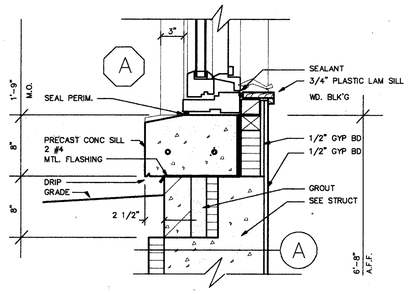

2 WINDOW SILL
1 1/2"

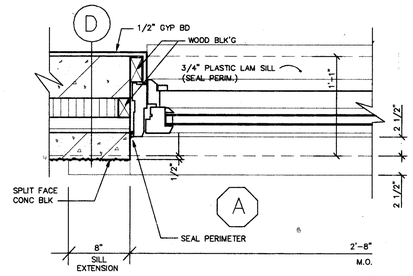

3 WINDOW JAMB
1 1/2"

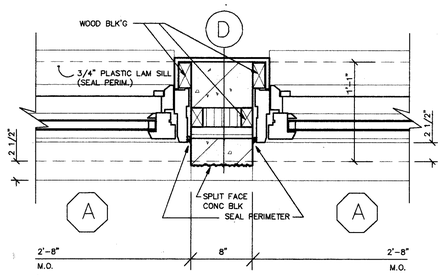

4 WINDOW MULLION
1 1/2"

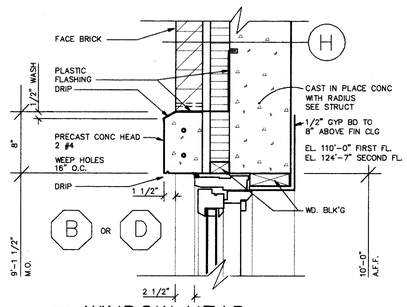

5 WINDOW HEAD
1 1/2"

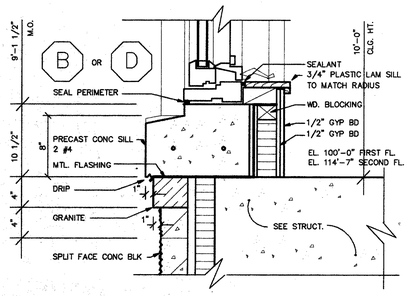

6 WINDOW SILL
1 1/2"

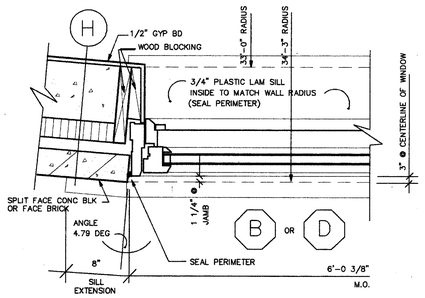

7 WINDOW JAMB
1 1/2"

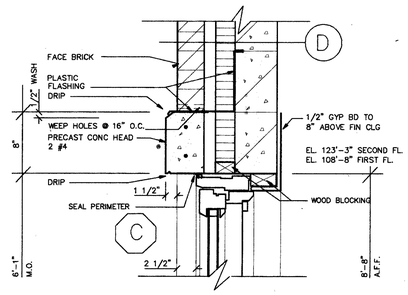

8 WINDOW HEAD
1 1/2"

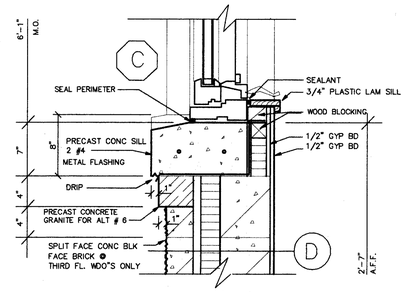

9 WINDOW SILL
1 1/2"

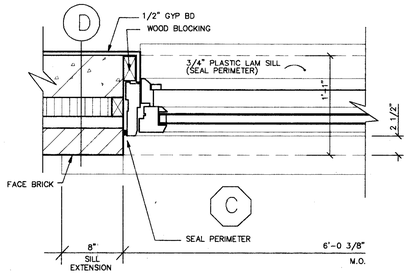

10 WINDOW JAMB
1 1/2"

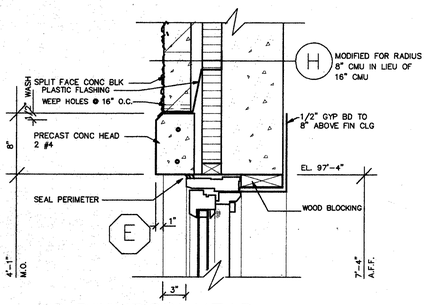

11 WINDOW HEAD
1 1/2"

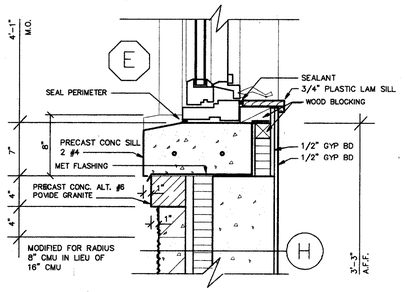

12 WINDOW SILL
1 1/2"

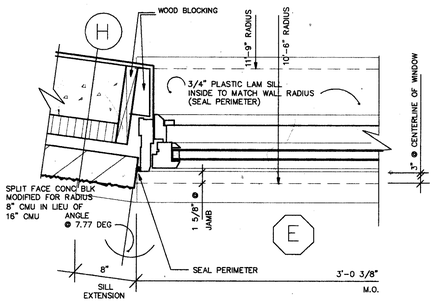

13 WINDOW JAMB
1 1/2"

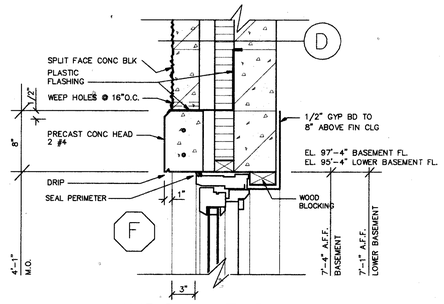

14 WINDOW HEAD
1 1/2"

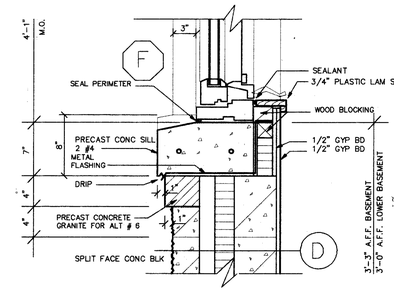

15 WINDOW SILL
1 1/2"

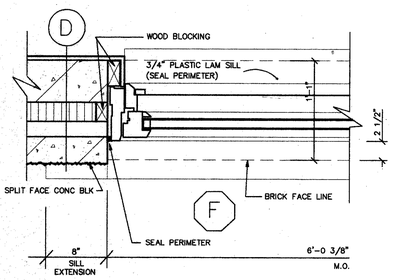

16 WINDOW JAMB
1 1/2"

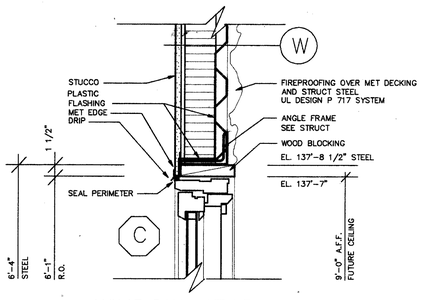

17 WINDOW HEAD
1 1/2"

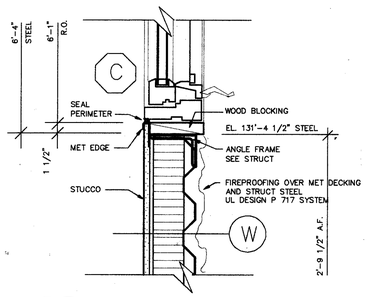

18 WINDOW SILL
1 1/2"

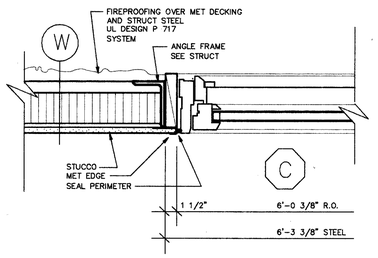

19 WINDOW JAMB
1 1/2"

GENERAL NOTES

PACK ALL WDO SHIM SPACES W/ INSULATION TYPICAL

PROJECT MARATHON COUNTY PUBLIC LIBRARY
ADDITION AND REMODELING
WAUSAU, WISCONSIN
HSR L920154

DRAWING WINDOW DETAILS
DATE JUNE 1993
DRAWN BY MLJ
REVISION

FILE # 92154A34
LAST UPDATE 6-18-93

HSR ASSOCIATES INC
ARCHITECTURE
ENGINEERING
LA CROSSE AND MADISON WI

A34